


Drainage section to be Displaced

Proposed Drainage throw Taxiways bridges

Drainage section to be Extended

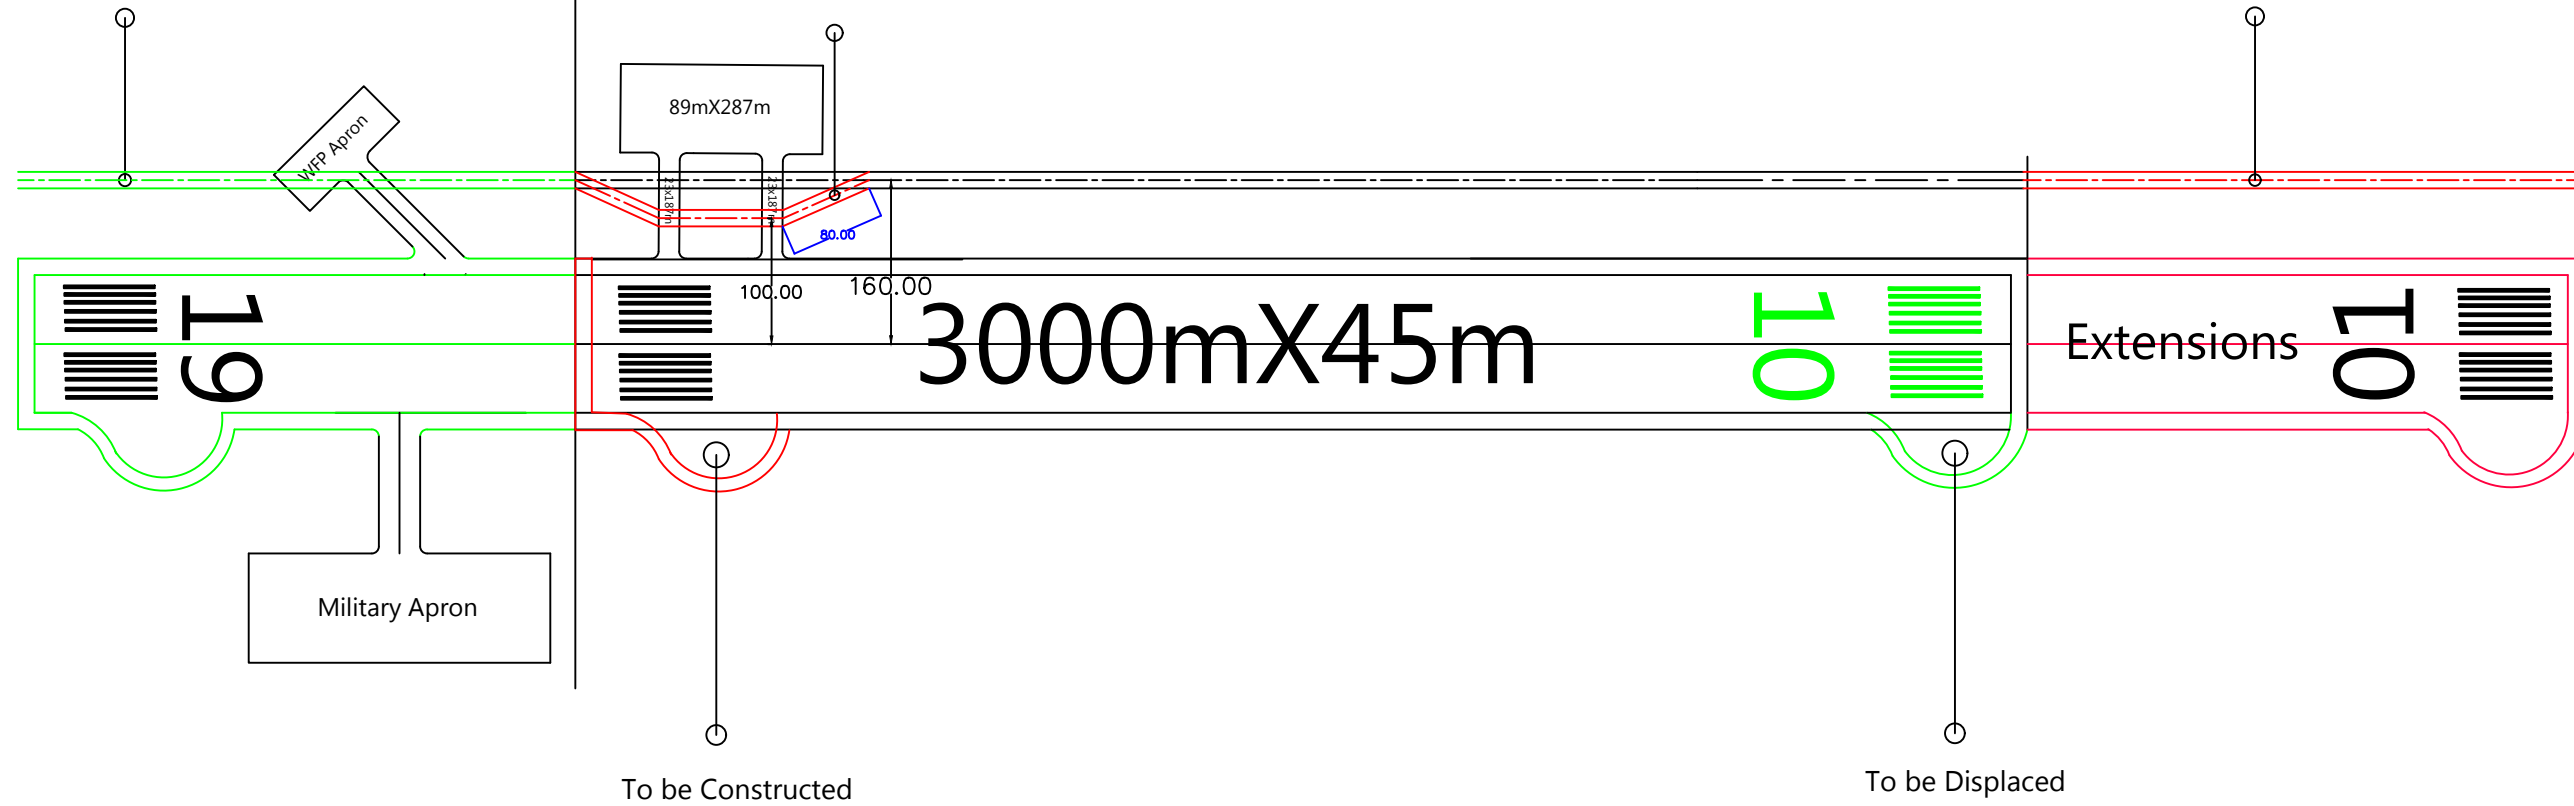

General Notes:

1. Layout is not to scale for Representation Purposes.
2. All Dimension are in meters unless Specified.
3. Green Area (Mainly North) Represents Area to be Displaced.
4. Red Area represents Extension or construction Area.
5. Drainage Length = 3000m Before & After Extensions works.
6. Drainage center Located 160m East of Runway CenterLine.
7. Drainage Disposal: Water Runs from South (Highest Point) to North (Lowest Point).
8. proposed Behavior of the Drainage At Taxiways clarified in (Red Line).

Drawn By :

Mohab Khaled Hassan

Checked By:

ENG.Moh . Hamdan

Approved By:

Consultant Eng. A.Magid



Consultant :-

Aerodromes Engineering Consultancy Company
Planning And Design Directorate

PROJECT:

Al-Obeid Airport Rehabilitation of Manuvering Area.

Drawing Title:

Airport Layout - Drainage Displacement & Extension

Project: Al-Obeid Airport Rehabilitation of Manuvering Area.

Date: 15/12/2017

Scale: As Shown

Sheet No:
HSOB-119